


This material and the information herein is the property of
Fuji Electric Systems Co., Ltd.. They shall be neither reproduced,
copied, lent, or disclosed in any way whatsoever for the use of any
third party, nor used for the manufacturing purposes without
the express written consent of Fuji Electric Systems Co., Ltd.

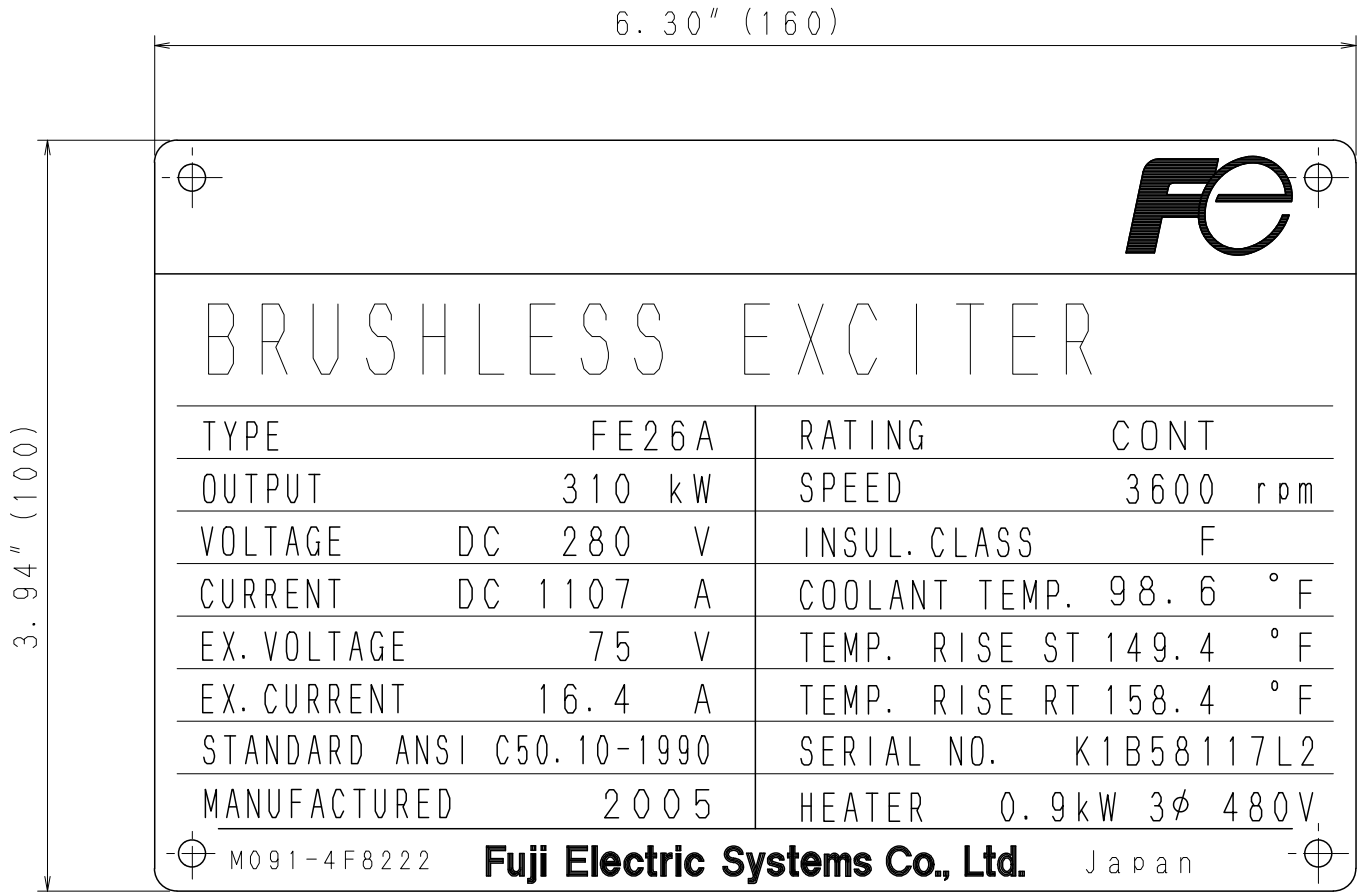

~~0.45kW~~ (b)

MATERIAL : SUS304

~~NOTE) EX. CURRENT WILL BE ETCHED AFTER HOME TEST.~~

AS FINAL

Fibrominn Biomass
Power Plant

REVISIONS	B) Revised Oct. -04-2005 K. Kawamata	白石	DRAWN	Kaw, Y. ku	APPROVED		SCALE	1 : 1	TITLE	NAME PLATE OF EXICITER	DRAWING NO. DWG CODE	CONTROL No. G-TD-1003-2		a b
			CHECKED	Kawamata	安井 白石									
	A) Revised Sep. -14-2005 K. Kawamata	白石	DATE	Mar. -18-2005		REF.								
			Fuji Electric Systems Co., Ltd.											