



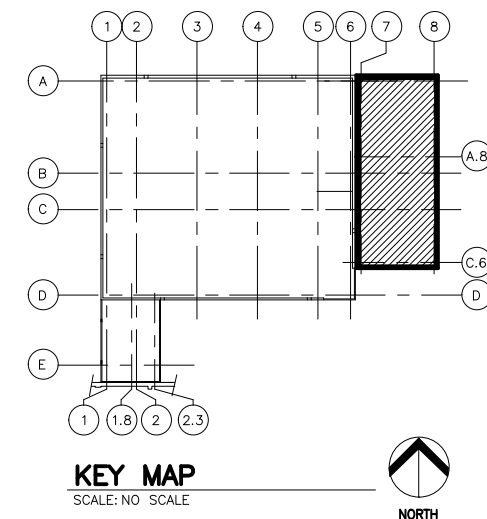

1 SUITE 124 PLAN  
1/2"=1'-0"

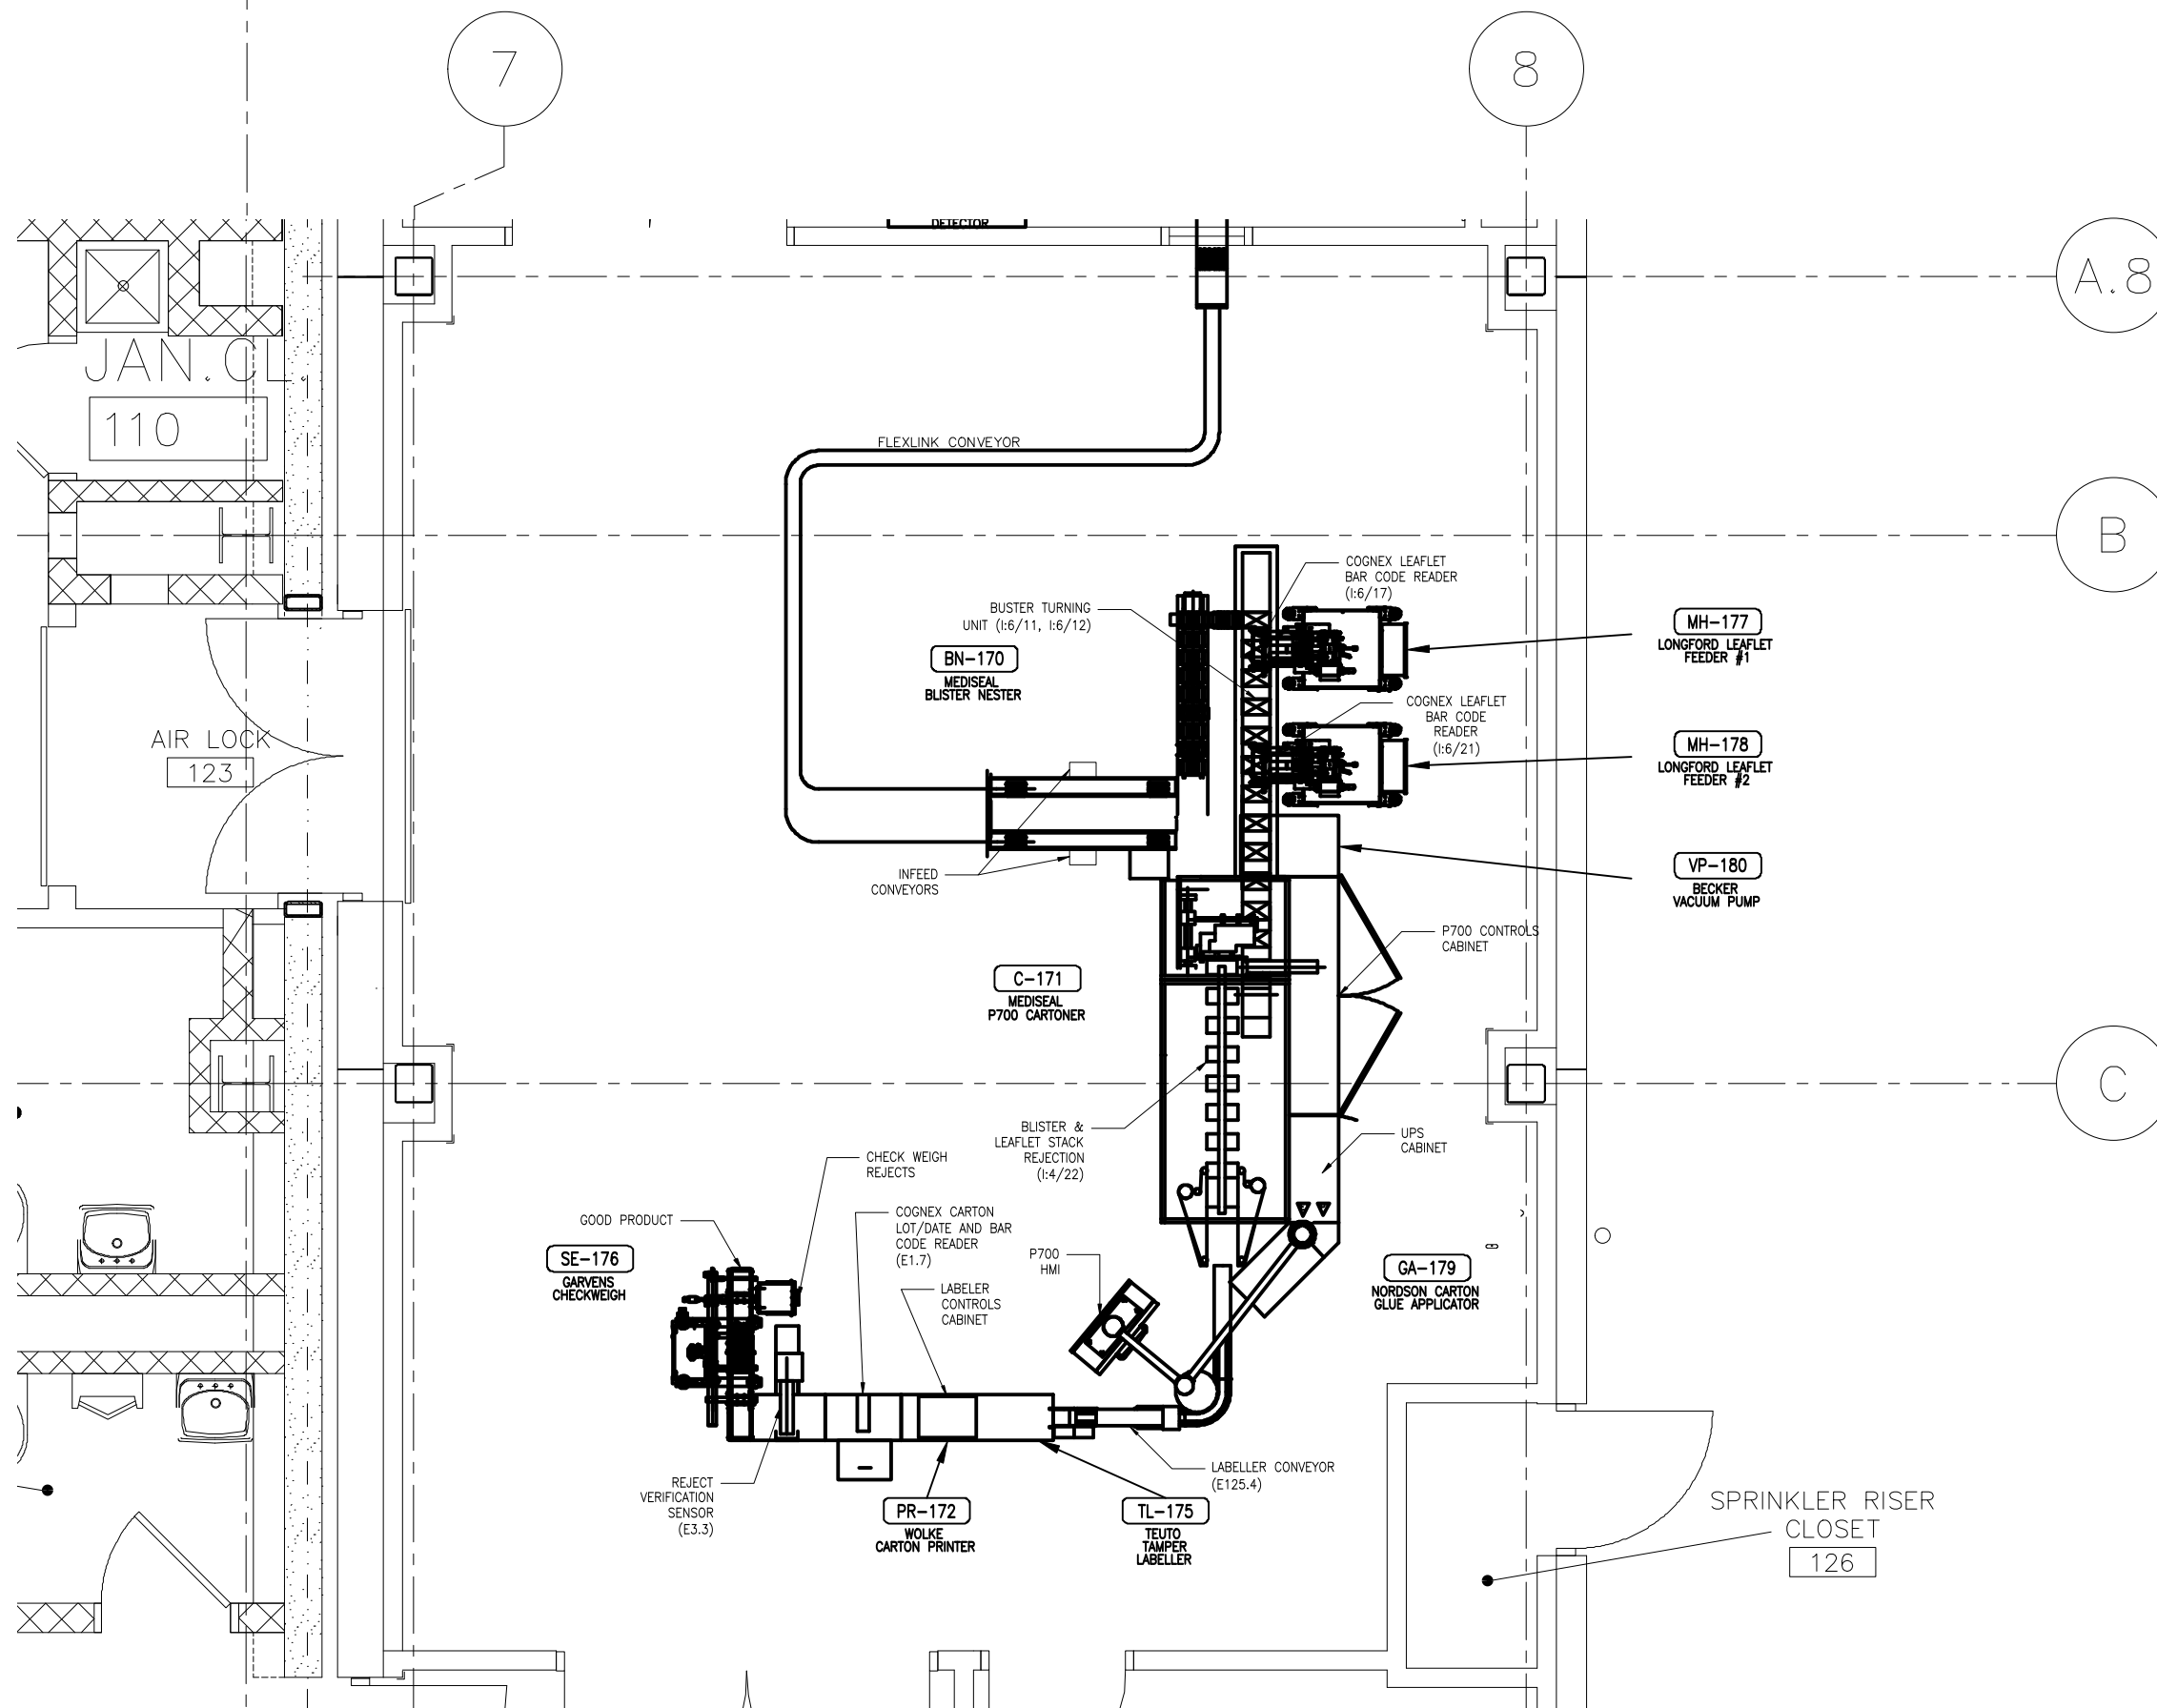

|                                                                                                                                                                                                                                          |            |              |                        |
|------------------------------------------------------------------------------------------------------------------------------------------------------------------------------------------------------------------------------------------|------------|--------------|------------------------|
| 2                                                                                                                                                                                                                                        | 02/22/11   | S.L.         | PROJECT MK725 AS BUILT |
| 1                                                                                                                                                                                                                                        | 04/06/10   | M.H.         | PROJECT MK725 AS BUILT |
| NO.                                                                                                                                                                                                                                      | DATE       | ENGR.        | DESCRIPTION            |
| DRAWING REVISIONS                                                                                                                                                                                                                        |            |              |                        |
| JOB NO.                                                                                                                                                                                                                                  | 086778.00  |              | PROJECT NO. MK725      |
| <div> COVIDIEN</div>                                                                                                                                |            |              |                        |
| BUILDING 5 – ANNEX<br>EQUIPMENT ARRANGEMENT<br>SUITE 124 PLAN                                                                                                                                                                            |            |              |                        |
| SITE                                                                                                                                                                                                                                     | STL        | PLANT 1      | BLDG. 5 FLOOR ROOF     |
| SCALE                                                                                                                                                                                                                                    | 1/2"=1'-0" |              | DATE 1/27/2010         |
| DR. BY:                                                                                                                                                                                                                                  | JLC        |              | ENGR. M.H.             |
| CHECKED                                                                                                                                                                                                                                  | RMV        |              |                        |
| DRAWING NO.                                                                                                                                                                                                                              |            | 0005-250-006 |                        |
| <div><p>THIS DRAWING IS THE PROPERTY OF COVIDIEN LTD. (OR ITS SUBSIDIARY) AND IS NOT TO BE REPRODUCED, COPIED OR USED FOR ANY PURPOSE EXCEPT AS SPECIFIED BY COVIDIEN LTD.</p><p>© 2007 Mallinckrodt Inc. All rights reserved.</p></div> |            |              |                        |